ARCHITECTS, INC. AIA 199 FIGUEROA ST, SUITE 100A VENTURA CA 93001

ARCHITECTURAL ASSISTANT

STAMP & SIGNATURE

STAMP & SIGNATURE

- EXCEPT THAT LEVEL CHANGES DO NOT EXCEED 1/4"VERTICAL. THE PATH SURFACE IS SLIP RESISTANT, STABLE, FIRM, AND SMOOTH.
- PASSING SPACES AT LEAST 60" X 60" ARE LOCATED NOT MORE THAN 200' APART. CONTINUOUS GRADIENTS HAVE 60" LEVEL AREAS NOT MORE THAN 400' APART.
- SLOPE IN THE DIRECTION OF TRAVEL IS LESS THAN 5% UNLESS OTHERWISE INDICATED AS A RAMP. MAINTAIN POT FREE OF OVERHANGING OBSTRUCTIONS TO 80" MINIMUM, PROTRUDING OBJECTS GREATER THAN 4" PROJECTION FROM WALL OR EDGE


AND 27" ABOVE FINISH GRADE.

FOR GRATINGS LOCATED IN THE SURFACE OF ANY PEDESTRIAN WAYS AT PATH OF DIRECTION OF TRAFFIC FLOW. IF SUCH CONDITION OCCURS, PROVIDE MANUFACTURER CUTSHEETS OF GRATE PROVIDED.

GATES SERVING THE MEANS OF EGRESS SYSTEM SHALL COMPLY WITH THE REQUIREMENTS OF SECTION 1008. GATES USED AS A COMPONENT IN A MEANS OF EGRESS SHALL CONFORM TO THE APPLICABLE REQUIREMENTS FOR DOORS. PROVIDE LEVER HARDWARE AND KICKPLATE. FIRE AND LIFE SAFETY MAY REQUIRE PANIC HARDWARE FOR EMERGENCY EXITING EVEN WITH THE SIGN. COORDINATE WITH FIRE AND LIFE SAFETY REQUIREMENTS.

DESIGN PROFESSIONAL IN GENERAL RESPONSIBLE CHARGE STATEMENT THE POT IDENTIFIED IN THESE CONSTRUCTION DOCUMENTS IS COMPLIANT WITH THE CURRENT APPLICABLE CALIFORNIA BUILDING CODE ACCESSIBILITY PROVISIONS FOR PATH OF TRAVEL REQUIREMENTS FOR ALTERATIONS, ADDITIONS AND STRUCTURAL REPAIRS. AS PART OF THE DESIGN OF THIS PROJECT, THE POT WAS EXAMINED AND ANY ELEMENTS, COMPONENTS OR PORTIONS OF THE POT THAT WERE DETERMINED TO BE NON COMPLIANT

1. HAVE BEEN IDENTIFIED 2. THE CORRECTIVE WORK NECESSARY TO BRING THEM INTO COMPLIANCE HAS BEEN INCLUDED WITHIN THE SCOPE OF THIS PROJECT'S WORK THROUGH DETAILS, DRAWINGS AND SPECIFICATIONS INCORPORATED INTO THESE CONSTRUCTION DOCUMENTS. DURING CONSTRUCTION. IF POT ITEMS WITHIN THE SCOPE OF THE PROJECT REPRESENTED AS CODE COMPLIANT ARE FOUND TO BE NON CONFORMING BEYOND REASONABLE CONSTRUCTION TOLERANCES, THEY SHALL BE BROUGHT INTO COMPLIANCE WITH THE CBC AS PART OF THIS PROJECT BY MEANS OF A CONSTRUCTION CHANGE DOCUMENT.

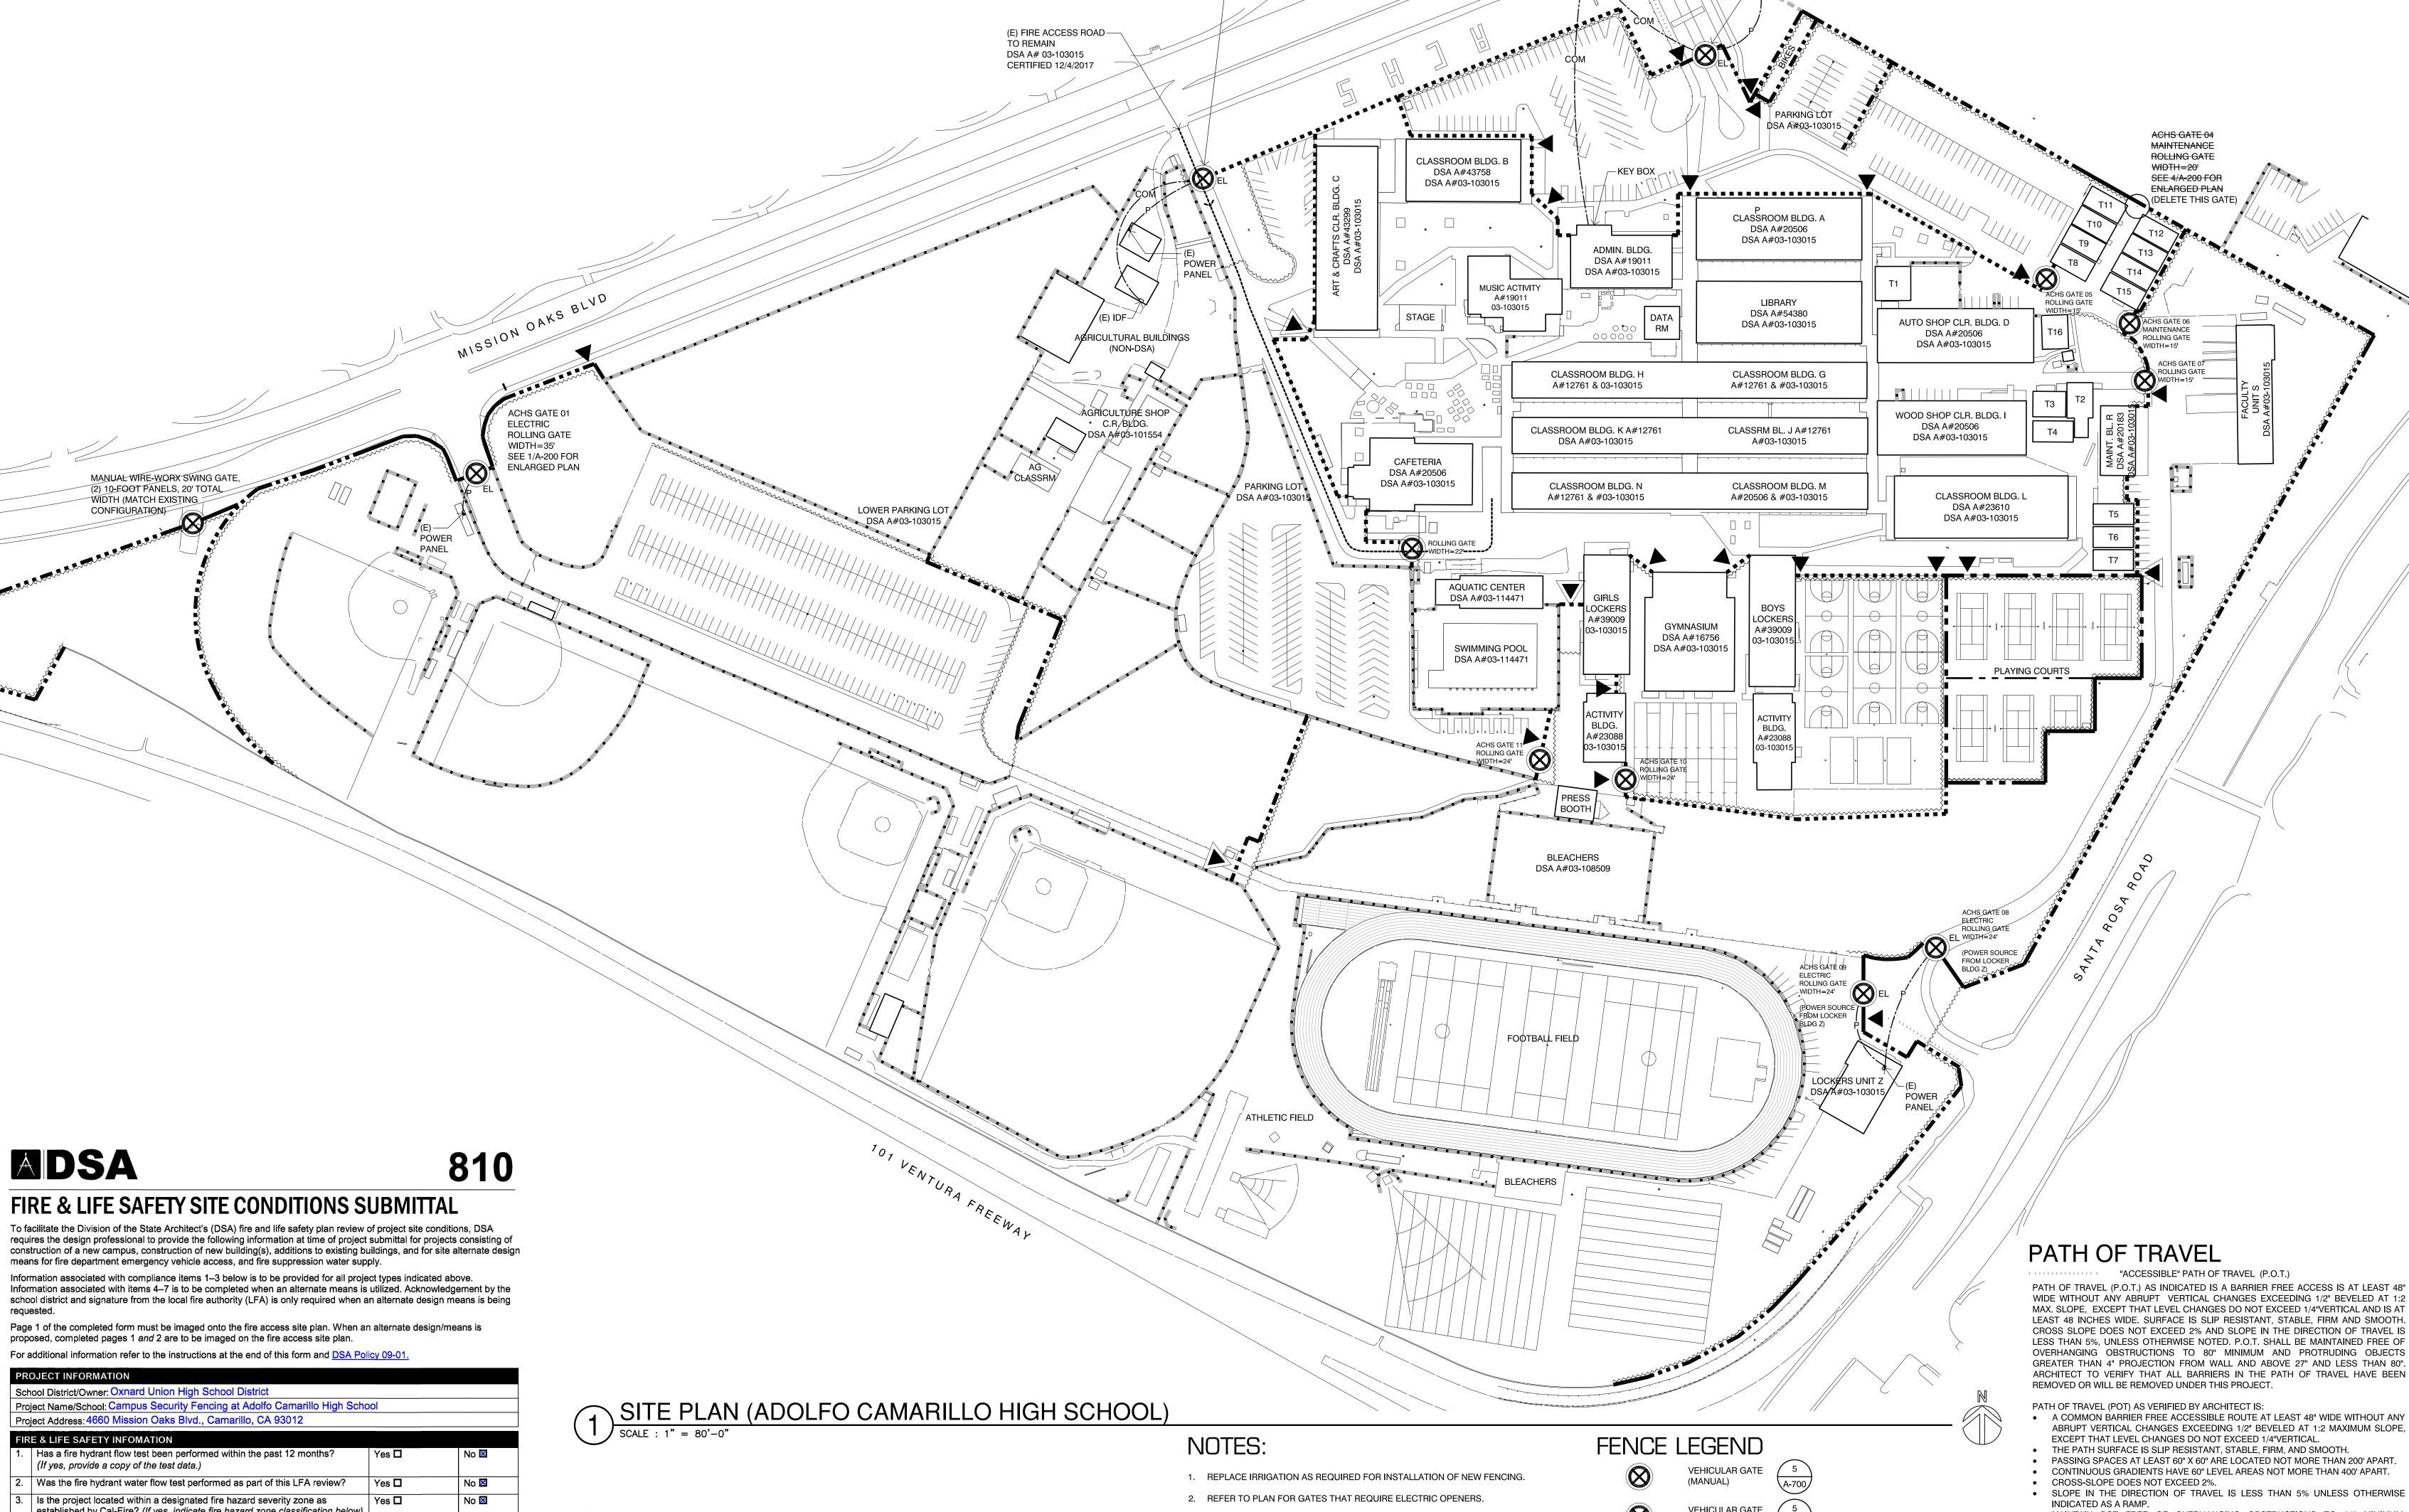

— ACHS GATE 02

ROLLING GATE

SEE 2/A-200 FOR

ENLARGED PLAN

(E) MARQUE SIGN--

ADMIN FOR COM

CONNECT VIA SIGN TO

ELECTRIC

WIDTH=24'

To facilitate the Division of the State Architect's (DSA) fire and life safety plan review of project site conditions, DSA requires the design professional to provide the following information at time of project submittal for projects consisting of means for fire department emergency vehicle access, and fire suppression water supply.

Information associated with compliance items 1–3 below is to be provided for all project types indicated above.

proposed, completed pages 1 and 2 are to be imaged on the fire access site plan.

Proj	ect Address: 4660 Mission Oaks Blvd., Camarillo, CA 93012					
FIRI	E & LIFE SAFETY INFOMATION					
1.	Has a fire hydrant flow test been performed within the past 12 months? (If yes, provide a copy of the test data.)	Yes 🗆	Yes 🗖		No 🗷	
2.	Was the fire hydrant water flow test performed as part of this LFA review?	Yes 🗆	Yes 🗆		No 🗵	
3.	Is the project located within a designated fire hazard severity zone as established by Cal-Fire? (If yes, indicate fire hazard zone classification below)	Yes 🗖	′es □		No 🗵	
	Refer to the following for fire hazard zone locations: www.fire.ca.gov/fire_prevention/fire_prevention_wildland_zones_maps	Moderate	oderate High		Very High	
	Wildland Interface Area (WIFA) (If any designations are checked, project design requirements of CBC Chapter 7A.)	n must meet	ust meet the			
СО	NDITION MEANS AND METHODS RESOLUTION	AL TE	DNATE	ACCE	DTE	
		Yes	No	N/A	N/F	
4.	Emergency vehicle access roadways do not meet CFC requirements.			X		
4a.	Acceptable Alternate: Emergency vehicle and personnel access as proposed by the project architect is acceptable for providing fire suppression and protection of life and property.					
5.	Fire Hydrants: Number and spacing does not meet CFC requirements			X		
5а.	Acceptable Alternate: Number of fire hydrants and spacing as propos by the project architect is acceptable for fire suppression and protection of life and property.					
6.	Fire Hydrants: Water flow and pressure are less than CFC minimum.				×	
6a.	Acceptable Alternate : The available flow and pressure is acceptable for providing fire suppression and protection of life and property.	or				
7.	Location of fire department connection(s) serving fire sprinkler systems standpipe systems does not meet CFC requirements.	or		X		
7a.	Acceptable Alternate: The location of fire department connection					

DEPARTMENT OF GENERAL SERVICES

STATE OF CALIFORNIA

DSA 810 (rev 10-22-18)

DIVISION OF THE STATE ARCHITECT

FIRE & LIFE SAFETY SITE CONDITIONS SUBMITTAL

School District Acceptance of Acceptable Design Alternates

By signing this form, the school district acknowledges and accepts the proposed design as an alternative to California Building Code (CBC) and California Fire Code (CFC) minimum requirements, as indicated by one or more of the conditions indicated at items 4a, 5a, 6a or 7a, for providing fire and life safety protection of life and

OCAL FIRE AUT:			FIRE	DEPARTMENT
FA Réview Official	JOHN	2000	Qa.	
	INSPECT	DR.		

3. POSTS: SQUARE TUBES 2-1/2" x 2-1/2" FORMED FROM NOMINAL THICKNESS, METALLIC-COATED STEEL SHEET OR FOR MED FROM .0625-INCH NOMINAL THICKNESS STEEL SHEET AND HOT DIP GALVANIZED AFTER FABRICATION.


4. POSTS AT NON-ACCESSIBLE SWING GATE OPENINGS: SQUARE TUBES 3" x

- STEEL SHEET OR FORMED FROM 0.105 INCH NOMINAL THICKNESS STEEL SHEET AND HOT DIP GALVANIZED AFTER FABRICATION. 5. POSTS AT ACCESSIBLE EGRESS GATE OPENINGS: SQUARE TUBES 4" x 4"
- 6. PROTECT EXISTING UTILITIES WITHIN WORK AREA. NOTIFY UNDERGROUND SERVICE ALERT AT LEAST 2 WORKING DAYS IN ADVANCE OF BEGINNING

EXCAVATION AT 1-800-422-4133.

FOR SINGLE-EGRESS OPENINGS AND 6" x 6" FOR DOUBLE-EGRESS

- 7. PLANS ARE DIAGRAMMATIC, CONTRACTOR SHALL PROVIDE ALL DEMOLITION INCIDENTAL OR REQUIRED TO COMPLETE THE SCOPE OF WORK WHETHER OR NOT IT IS SPECIFICALLY NOTED, INCLUDING, BUT NOT LIMITED TO ALL OTHER WORK THAT IS REASONABLY REQUIRED TO BE REMOVED IN PREPARATION FOR THE NEW WORK AND NEW FINISHES.
- 8. EXISTING BURIED CONDUITS/ PIPES/ STRUCTURES KNOWN ARE SHOWN ON THE DRAWINGS, BASED ON RECORD INFORMATION OR INPUT FROM OTHERS. THE LOCATIONS OF THOSE SHOWN ARE APPROXIMATE (SCHEMATIC) ONLY AND MOST LIKELY, OTHERS EXIST WHICH HAVE NOT BEEN SHOWN. THE CONTRACTOR SHALL BE RESPONSIBLE TO INVESTIGATE, LOCATE AND MARK ALL EXISTING BURIED CONDUITS, UTILITY LINES, PIPES AND STRUCTURES PRIOR TO START OF TRENCHING. PROTECT AND MAINTAIN IN SERVICE ALL SUCH FACILITIES UNTIL OTHERWISE APPROVED IN WRITING BY OWNER.

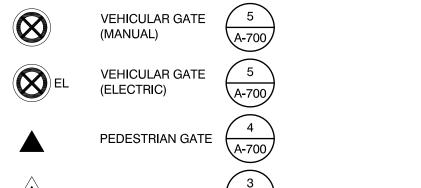

- ACHS GATE 03

SWING GATES

WIDTH=PER PLAN

SEE 3/A-200 FOR

ENLARGED PLAN

NOTE: ALL UNDERGROUND CONDUITS ARE

1" MIN. & 30" BELOW FINISHED GRADE WITH

TRACER TAPE ABOVE CONDUIT 12", TYP.

ELECTRIC

GOLF CART GATE (A-700) NOTE: 8' WIDE MIN. OPENING ATHLETIC FENCE (14 FT. HIGH ATHLETIC FENCE AT / 8 BASKETBALL & TENNIS COURTS) TENNIS COURTS: REMOVE EXISTING FENCE FABRIC & WIND NETTING; PAINT EXISTING FENCE POSTS & INSTALL NEW VINYL-COATED FENCE FABRIC & WIND SCREEN.

NOTE: ALL EXISTING GATES IN THE TENNIS COURT

ENCLOSURE SHALL HAVE THE FRAMES PAINTED &

THE FENCE FABRIC/ WIND SCREEN REPLACED. CORE FENCE (8 FT. HIGH VERTICAL WIRE MESH BY WIREWORKS PLUS) PERIMETER FENCE (8 FT. HIGH / 2

BY WIREWORKS PLUS) (E) FENCE TO REMAIN

(E) FENCE, GATES & FOOTINGS TO BE REMOVED

-/-/- XX <u> -</u> -/-/- XX 07/01/20 PP BID ADDENDUM 3 REVISION DESCRIPTION DATE BY DRAWN PP CHECKED TJ DATE 07/28/2020 JOB. NO. 19001 DSA A#03-120196 FILE: 56-H4 PTN: 72546-88

SHEET SITE PLAN

TITLE