


Question from Ardalan Construction: Can you please provide clarifications to the detail attached. The sleeve appears to be inside the HSS, but it is not clear.

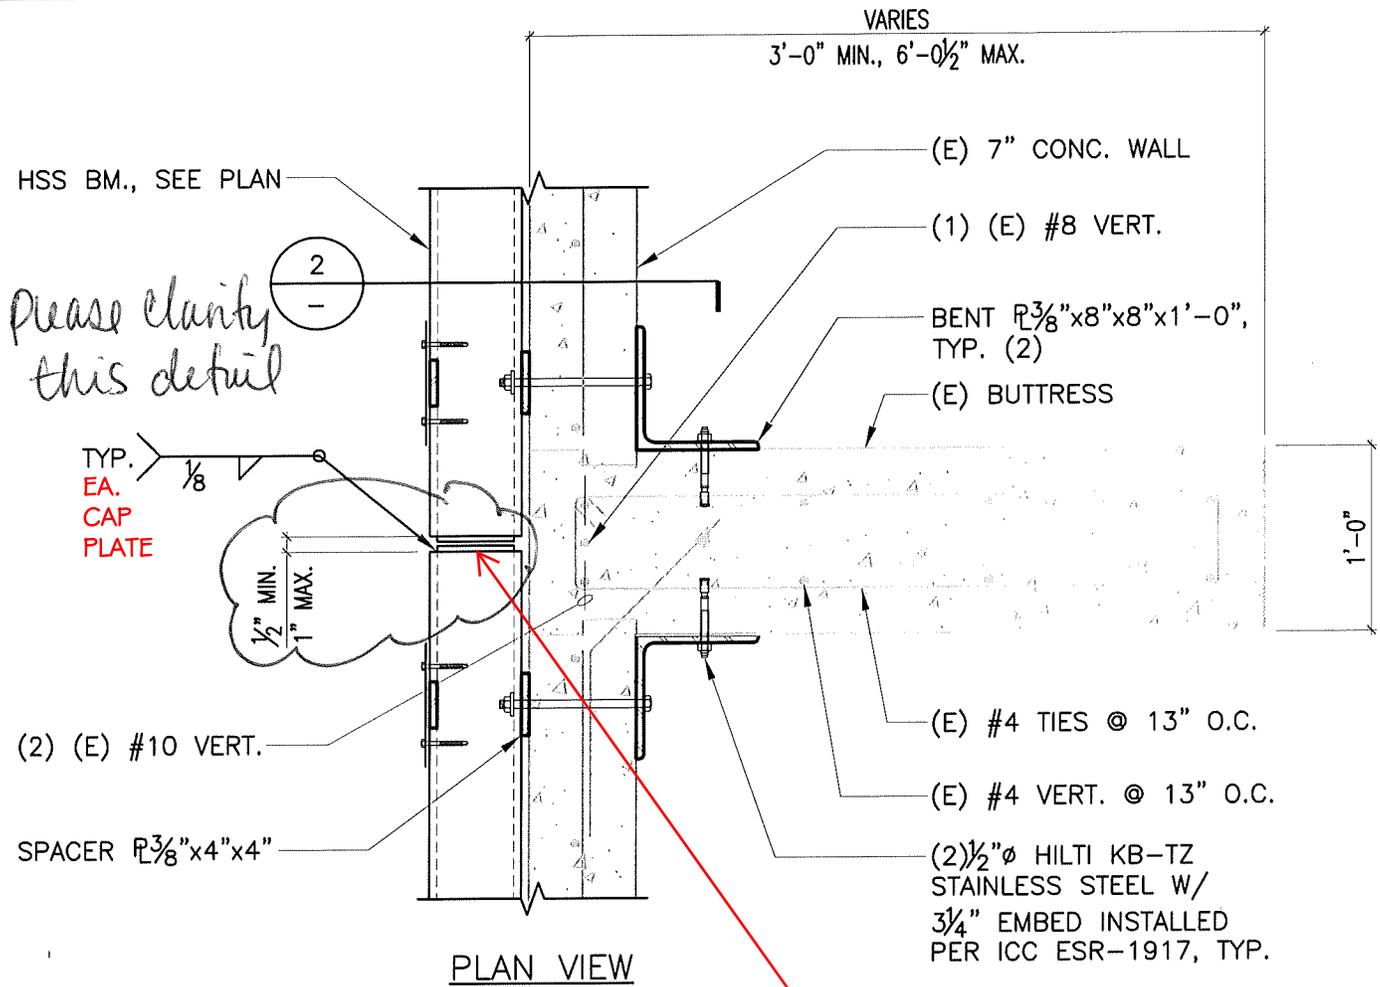

please clarify this detail

TYP. EA. CAP PLATE 1/8

1/2" MIN. 1" MAX.

PLAN VIEW

- NOTES:
1. FIELD LOCATE (E) REINF. PRIOR TO DRILLING.
 2. DO NOT DAMAGE (E) STL. REINF.
 3. USE NON-REBAR CUTTING DRILL BITS.

3/16" CAP PLATE, TYPICAL (2)

CIHS-003

SCALE: 1"=1'-0"

7 DETAIL

3

(F) STEEL REINFORCEMENT

NEW CORED HOLE

Note: The above markup in red colored font was provided by Architect/Engineer.