



Bid 658
Gym Bleacher Replacement Project for Adolfo Camarillo and Rio Mesa High Schools

BID CLARIFICATION ADDENDUM #1

Dated: January 16th, 2022

All interested parties seeking to submit responses to the Oxnard Union High School District's Bid #658 shall execute the certification at the end of this addendum and shall attach the addendum to the documents submitted to the District.

The Oxnard Union High School District hereby amends Bid 658 Gym Bleacher Replacement Project for Adolfo Camarillo and Rio Mesa High Schools as follows:

- 1) **Protection and Cleanup:** Wood Athletic flooring must be protected at all times. This being an active campus, clean-up must be done on a daily basis. This shall be inclusive in the base bid and will not be entertained as an argument for additional compensation.

- 2) **Laydown Area:** The contractor is responsible for receiving, verifying, and protecting the materials received for the project. The contractor has to discuss with the Construction Manager and establish a designated area within the first 30 days of awarding the project.

- 3) **At Adolfo Camarillo & Rio Mesa High Schools, the gym boys and girls toilet room work has been completed by the district.**

- 4) **Please refer to Attachment A – RFI response**

BIDDER'S CERTIFICATION

I acknowledge receipt of the foregoing Addendum # 1 and accept all conditions contained herein.

Dated: _____ **BIDDER:** _____
(company/entity)


By: _____ **Printed Name:** _____
(authorized representative signature)

Title: _____

Bid Clarification Addendum #1

Attachment A
RFI Response

Can you please provide clarifications to the detail attached. The sleeve appears to be inside the HSS, but it is not clear.

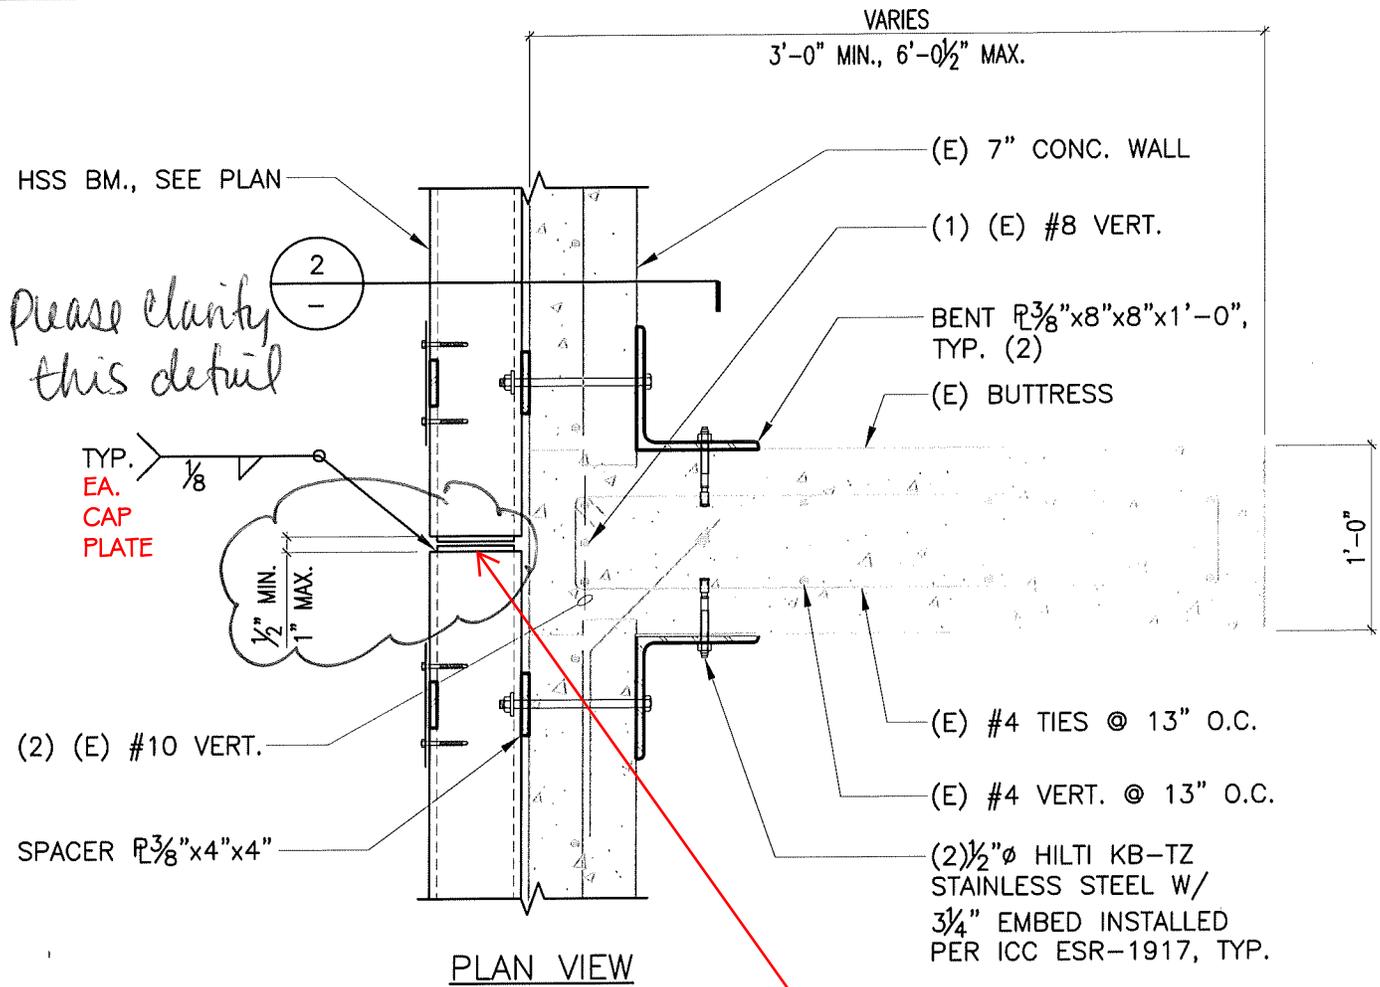

please clarify this detail

3/16" CAP PLATE, TYPICAL (2)

- NOTES:
1. FIELD LOCATE (E) REINF. PRIOR TO DRILLING.
 2. DO NOT DAMAGE (E) STL. REINF.
 3. USE NON-REBAR CUTTING DRILL BITS.

CIHS-003

SCALE: 1"=1'-0"

7 DETAIL

3

(E) STEEL REINFORCEMENT

NEW CORED HOLE

Note: The above markup in red colored font was provided by Architect/Engineer.